


# Air Handling Unit, AHU-201 Flow Diagram and Equipment Locations

## FIELD MATERIAL

DEVICE TAG	QTY	CODE NUMBER	DESCRIPTION
D-1	1	B-3153-2	SEE DAMPER SCHEDULE
DA-1	1	8021-CVP	DAMPER ACTUATOR 8-13N
ES-1	1	HE-6300-1	END SWITCH
H/TE-1	1	P32AF-2C	HUMID/TEMP TRANS; 0/100%
PS-1-PS-2	2	FTG18A-600R	SENSITIVE DIFF PRES CTL
SD-1	1	DA1851AC-2	REMOTE MTD PROBE
TE-1	1	ST-10	DUCT DETECTOR, 10N
TS-1	1	TE-6001-1	SAMPLING TUBE FOR
V-1-V-2	2	TE-6000-4	MOUNTING HARDWARE
ACC	1	A70MA-1C	1000 OHM, NI RTD
EP-1	1	G-2010-5	TEMP CONTROL 4 WIRE, 2-C
	1	V-2410-2	SEE VALVE SCHEDULE
	1		AIR GAGE 1-1/2"
	1		VALVE, SOL.AIR, 3-WAY

ANY MATERIAL WITH A (P) PRECEDING THE DEVICE TAG IS CONSIDERED PROPRIETARY EQUIPMENT AND IS BEING SUPPLIED BY JOHNSON CONTROLS, INC. ALL OTHER MATERIAL IS NON-PROPRIETARY EQUIPMENT.

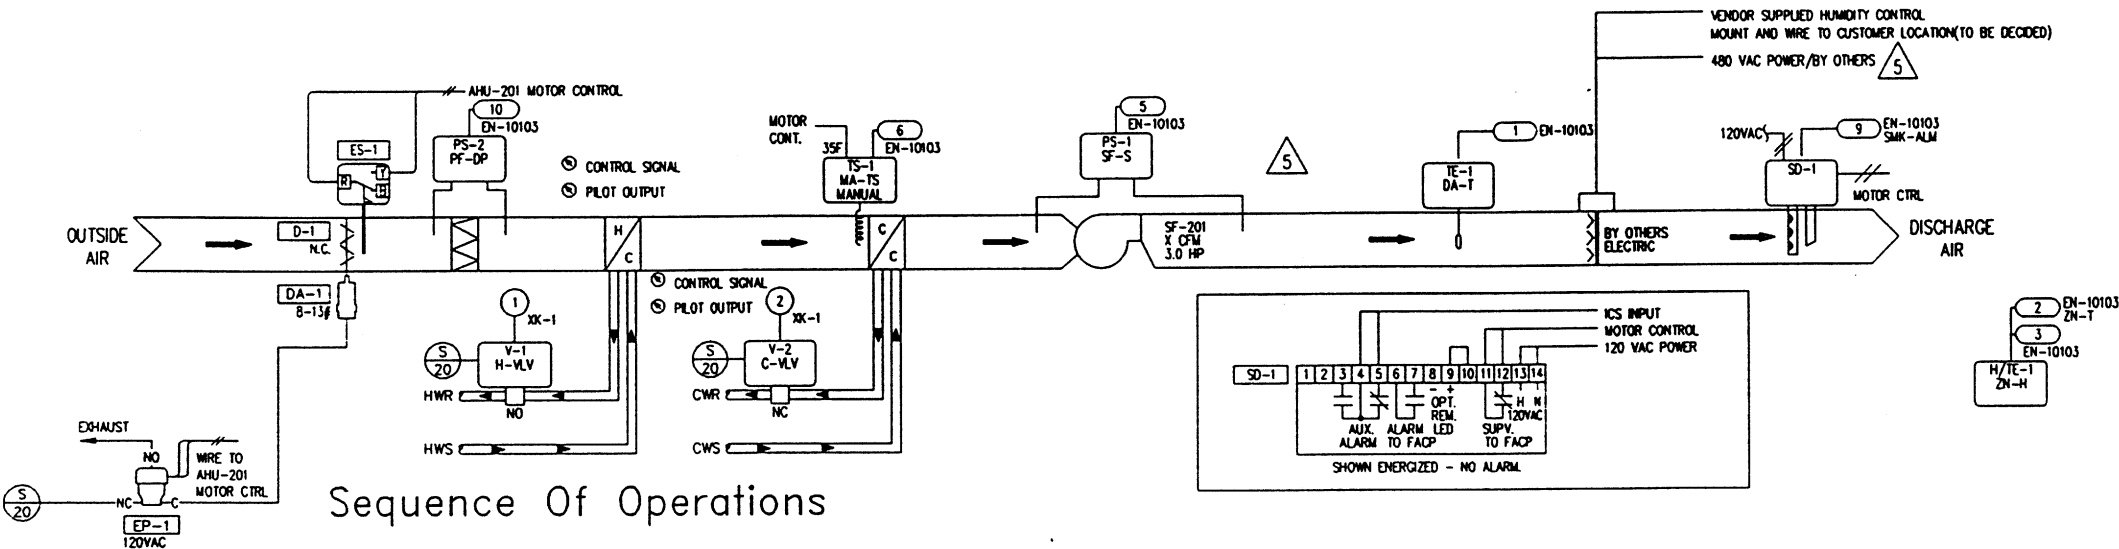

## Sequence Of Operations

SYSTEM: 100 Percent Outside Air Constant Volume Air Handling Unit AHU-201

CONFIGURATION: Single discharge air setpoint  
Constant Air Volume with one Supply Fan

### Occupied Mode

#### Discharge Air Temperature Setpoint

The building operating engineer will set the discharge air temperature by adjusting the discharge air setpoint, DA-SP from any ISC terminal. The digital controller will modulate controlled devices as described below to maintain a fan discharge temperature of 55 F.(Adjustable)

#### Discharge Temperature Loop

The discharge cooling deadband is added to the discharge air setpoint. This value establishes the point at which mechanical cooling begins when the controller uses proportional only control. The digital controller will continually adjust the damper and mechanical cooling command in sequence according to the controller's result of the proportional-integral cooling loop calculation. The digital controller modulates the controlled devices until the discharge air temperature equals the calculated discharge setpoint. The digital controller will continually adjust the heating command according to the controller's result of the proportional-integral heating loop calculation. The digital controller will modulate the heating control valve, V-1 until the discharge air temperature equals the setpoint. The controller will provide an output between 8 and 100 percent as the discharge air temperature travels through the proportional bands.

The state of 'Heating Mode' and 'Cooling mode' will lockout the operation of the controlled device, V-1 and V-2 if the respective mode is set 'OFF'. The PID control algorithm will sequence the heating and cooling devices so that both do not operate in the same proportional band.

#### Heating Mode

The digital controller will enter the heating mode at outdoor air temperatures below 45 F. The digital controller will position the cooling control valve at zero percent and the freeze protection pump will be turned on.

#### Cooling Mode

The digital controller will enter the cooling mode at outdoor air temperatures above 50 F. The digital controller will position the heating control valve at zero percent.

#### Warm-up/Cool-down

The warm-up/cool-down mode initiation will take place through a command from the higher level digital controller, NC-8 on a schedule basis. When mode active the AHU digital controller will start the fan system and will control at the occupied mode setpoints without the operation of the mixed air dampers. After the controller switches into the occupied mode, the mixed air system will be enabled.

#### Loss of Air Flow

Upon loss of air flow as determined by sensitive differential pressure switch, PS-1. The following controlled devices will be commanded to the following states:



- Heating valve, V-1 will remain in control.
- Cooling valve, V-2 will be positioned at zero percent.

#### Fan Status

Sensitive differential pressure switch, PS-1 will close upon air flow being present, this will set fan status ON. The digital AHU controller switch to normal control.

#### Humidity Control

Packaged humidifier will have self contained controls. An alarm will be provided from the humidifier to the ICS.

#### Unoccupied Mode

The supply fan will remain off and the controlled devices will be commanded to the positions indicated above under 'Loss of Air Flow'.

#### Power Fail Restart

The power fail restart will delay the startup of the digital controller for 1 minute (adjustable at the operator workstation) after a power failure for controller reset condition. This logic will hold the controller in the shutdown mode until the restart timer has expired.

Sensitive differential pressure switch, PS-2 will close and the AHU digital controller will send a primary filter alarm to the ISC network.

Heating discharge low limit temperature switch, TS-1 will stop the supply fan and the AHU digital controller will issue an alarm to the ISC network in the event that the heating discharge temperature drops below 35 F.(Adj.)

Supply smoke detector, SD-1 will open a control circuit and the AHU digital controller will issue an alarm to the ISC network in the event the respective device senses smoke at the location.



The following point objects will be adjustable from any ICS terminal:

- Discharge air setpoint
- Heating and Cooling lockout setpoints

The following point objects will be monitored/alarm at any ICS terminal:

- Electric low limit temperature switch, TS-1 status
- Mixed air filter differential pressure alarm, PS-3
- Supply fan status, PS-1
- Smoke detector, SD-1 status
- Humidifier alarm

## Motor Control

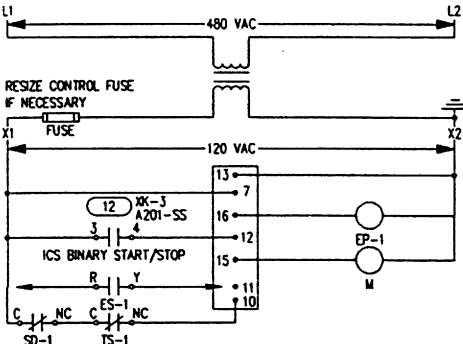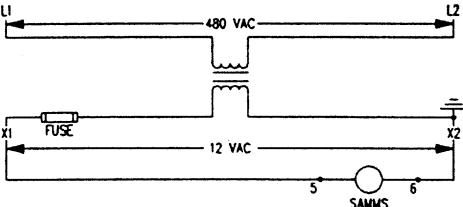

DRAWING TITLE		AS BUILTS		FILE: AHU-201H	
Air Handling Unit, AHU-201		4 GENERAL		DCODE: 19930628.1443	
Building 411, Linac Injection		3 GENERAL		09/19/91 DCS	
100 Percent Outside Air		NO REVISION-LOCATION		07/15/91 SF	
Single Path Htg/Clg Unit		SALES ENCR PROJECT MOR APPL ENCR		04/23/91 SF	
PROJECT		DATE 11/21/91		DATE	
The Argonne National Labs		DRAWN		APPROVED	
Advanced Photon Source Campus		JOHNSON CONTROLS		CONTRACT NUMBER	
9700 Cass Avenue South		Systems & Services Division		91390-0009	
Argonne, IL 60439		3007 WALDO ROAD		DRAWING NUMBER	
		ARLINGTON HEIGHTS		91-9-B-05A	
		ILLINOIS 60005			
		708/364-1500 Main			
		708/806-4438 Eng			